

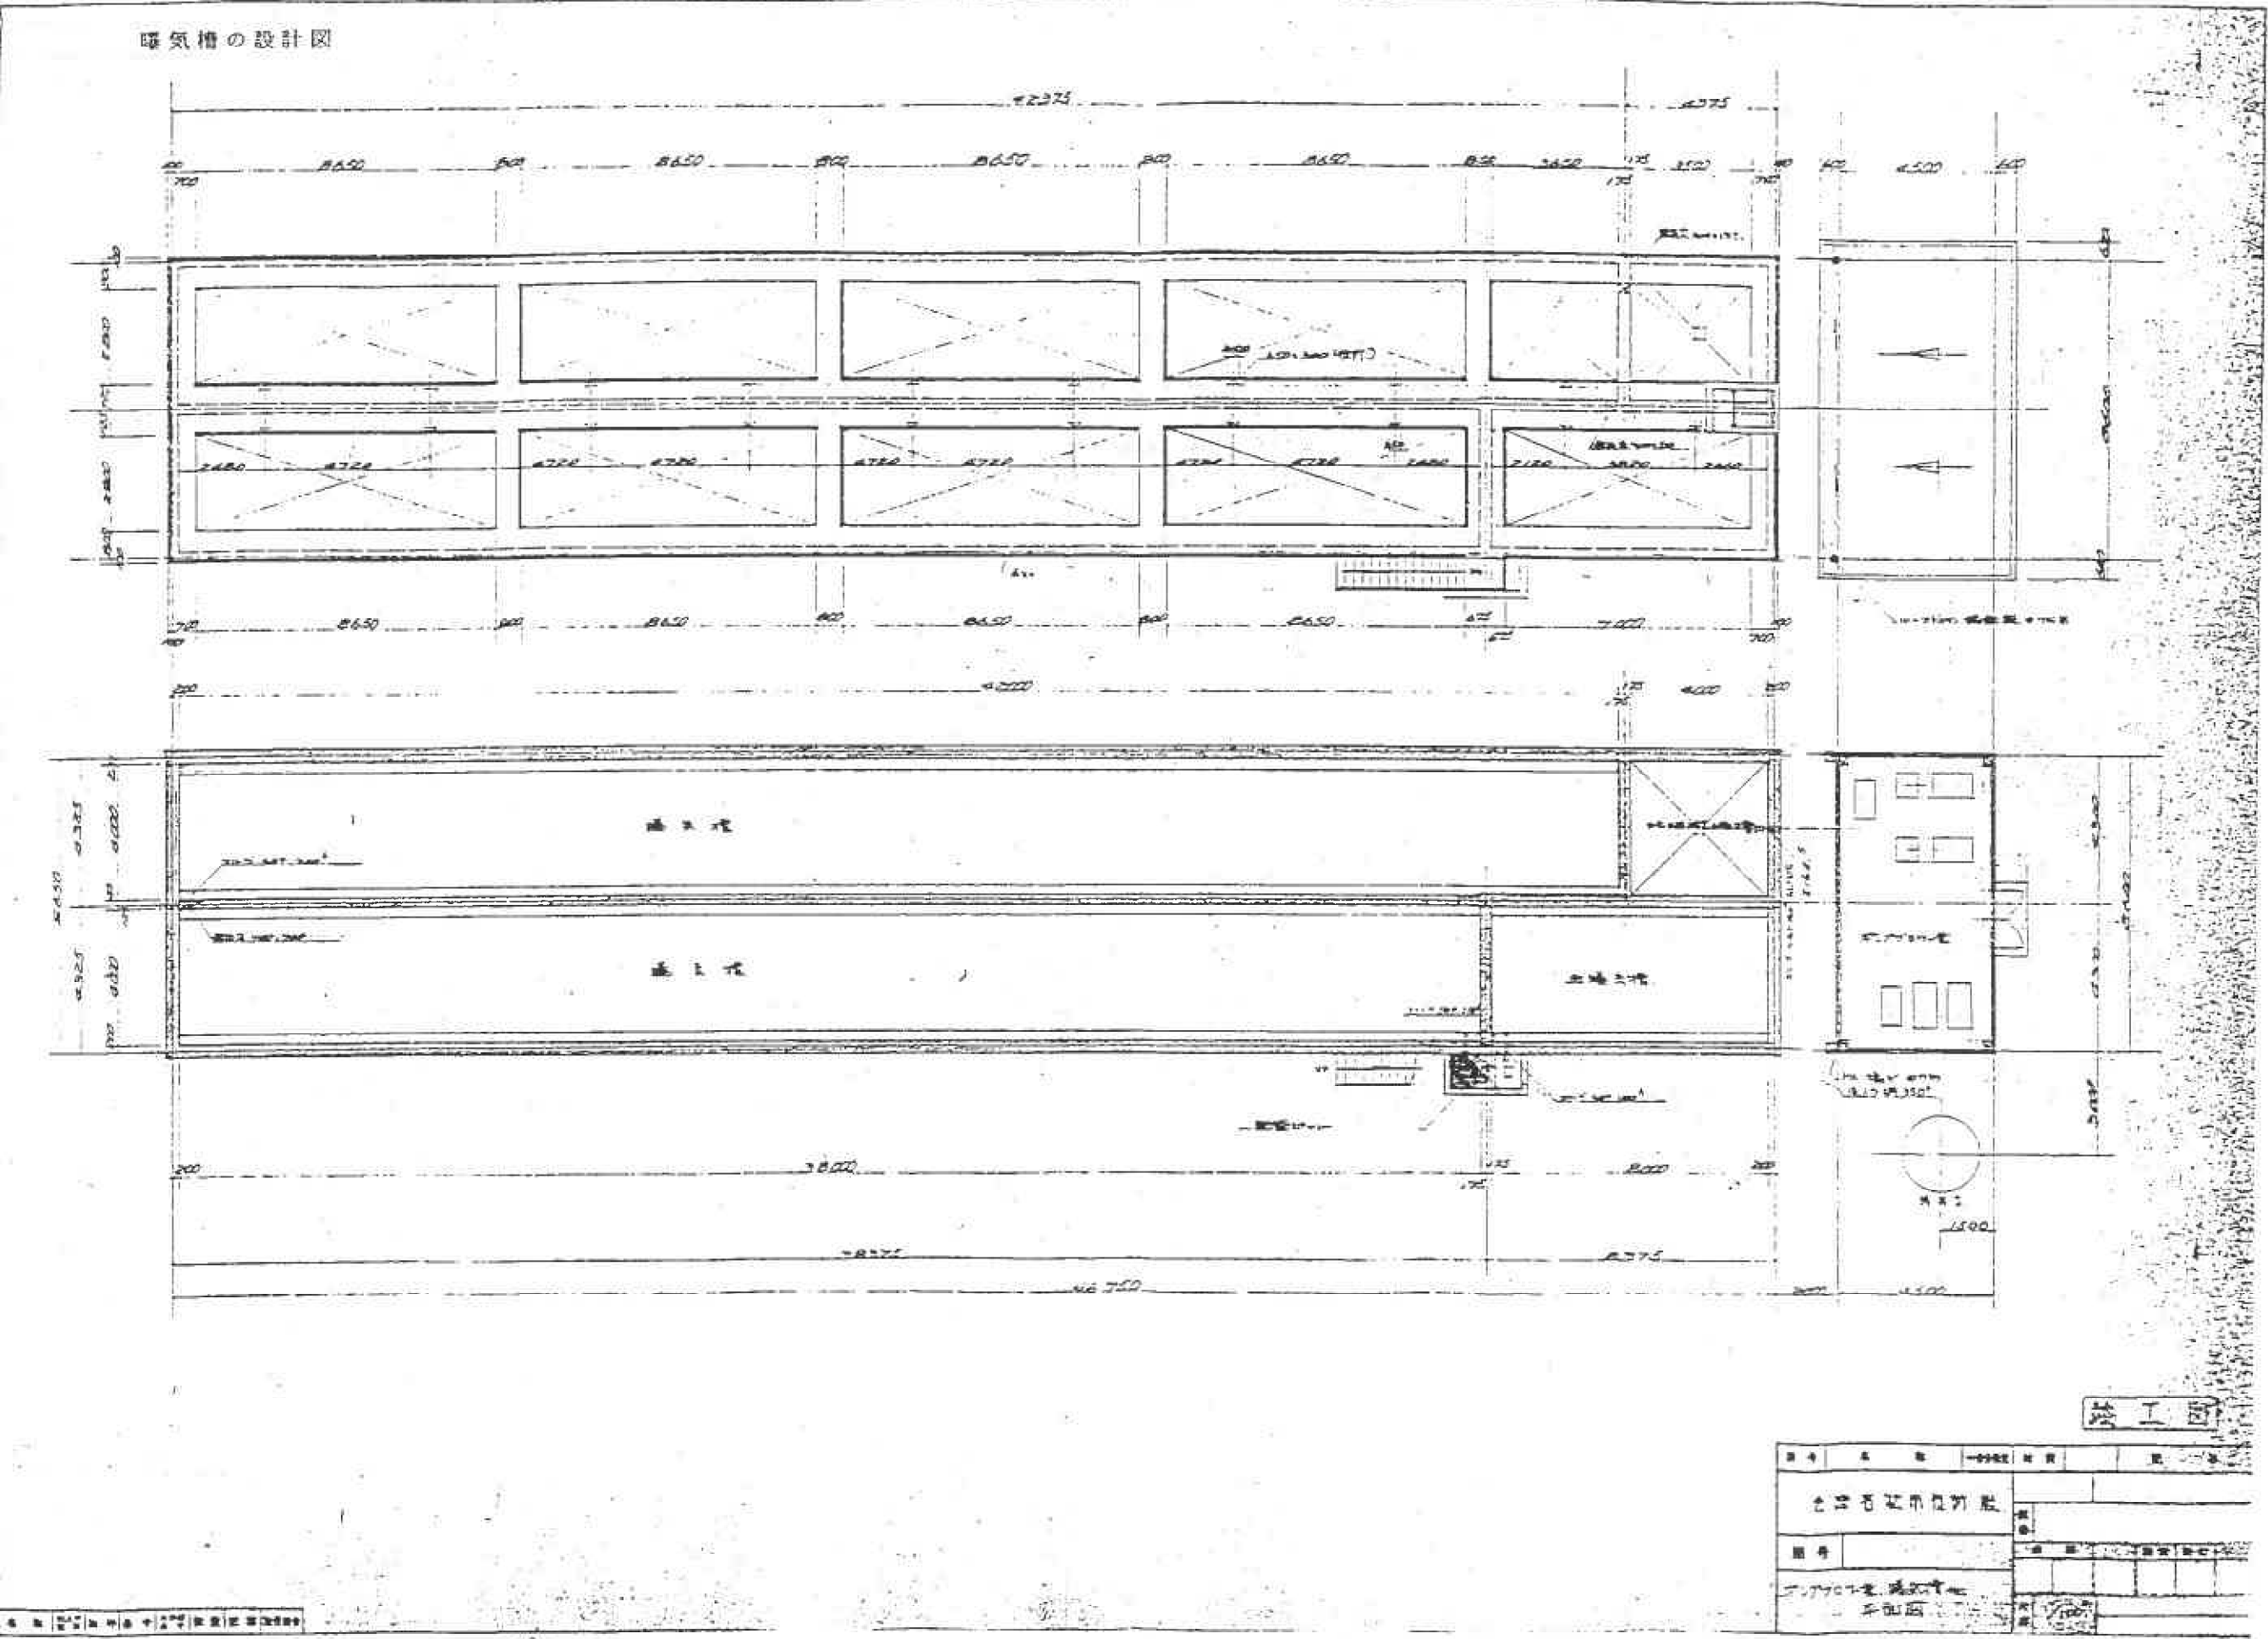


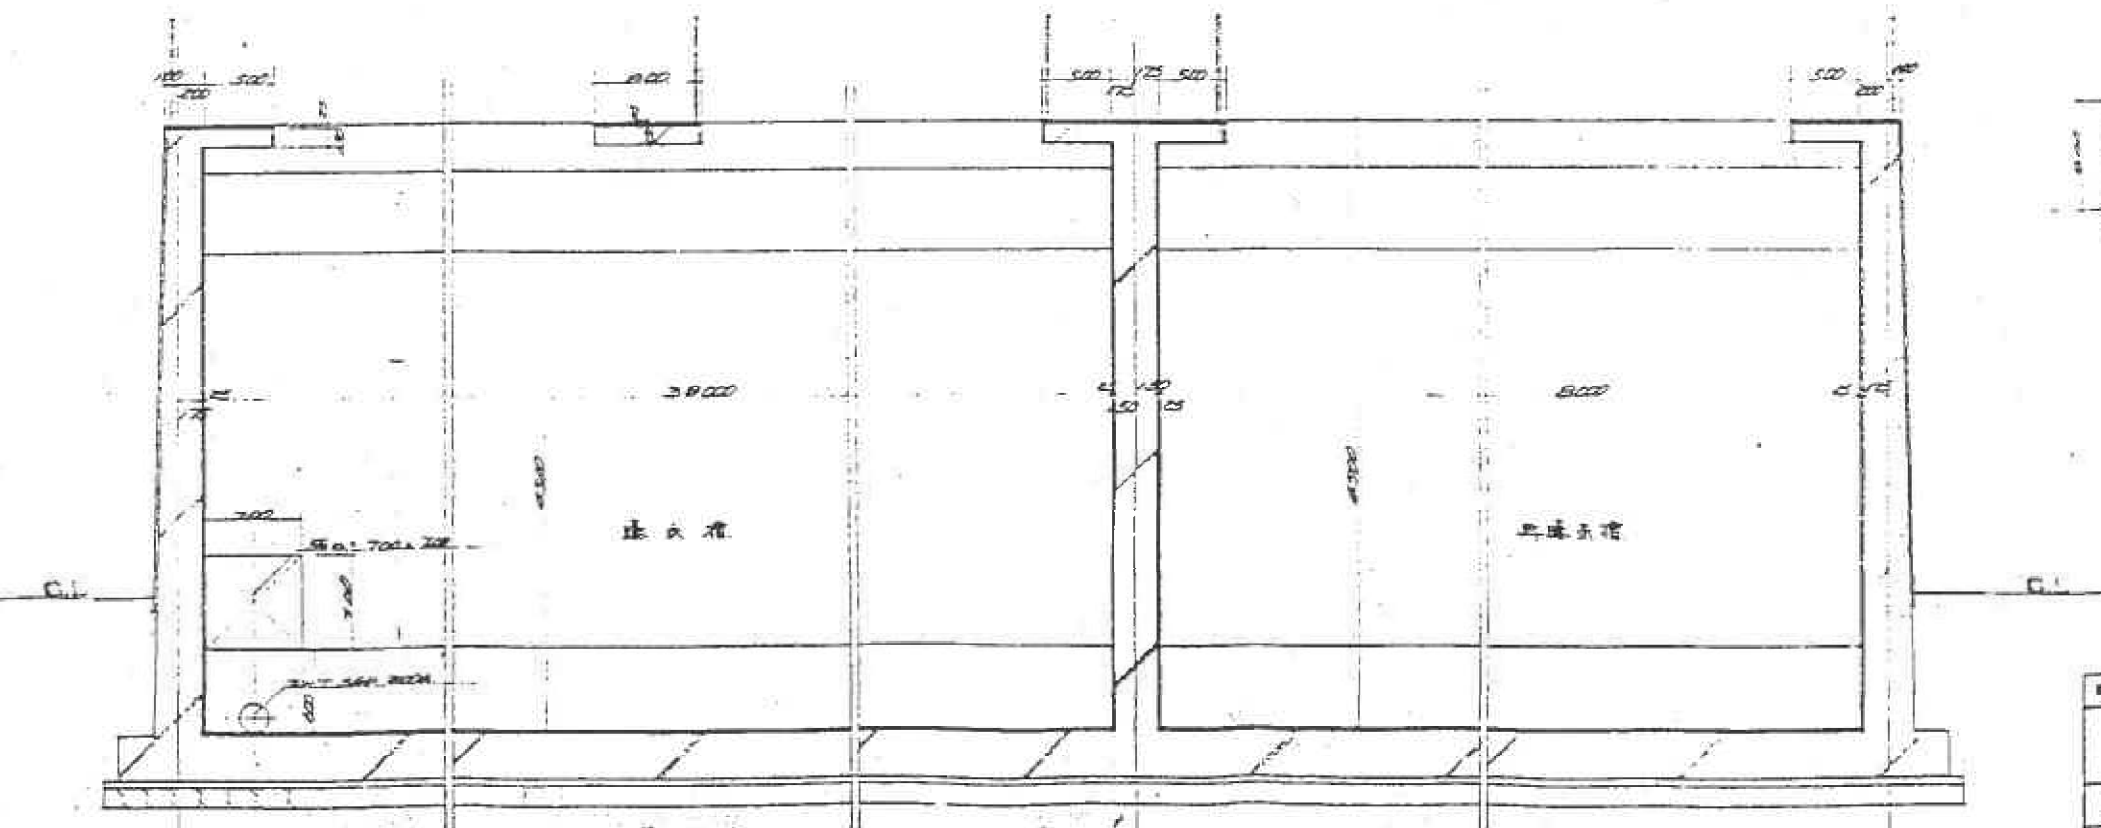






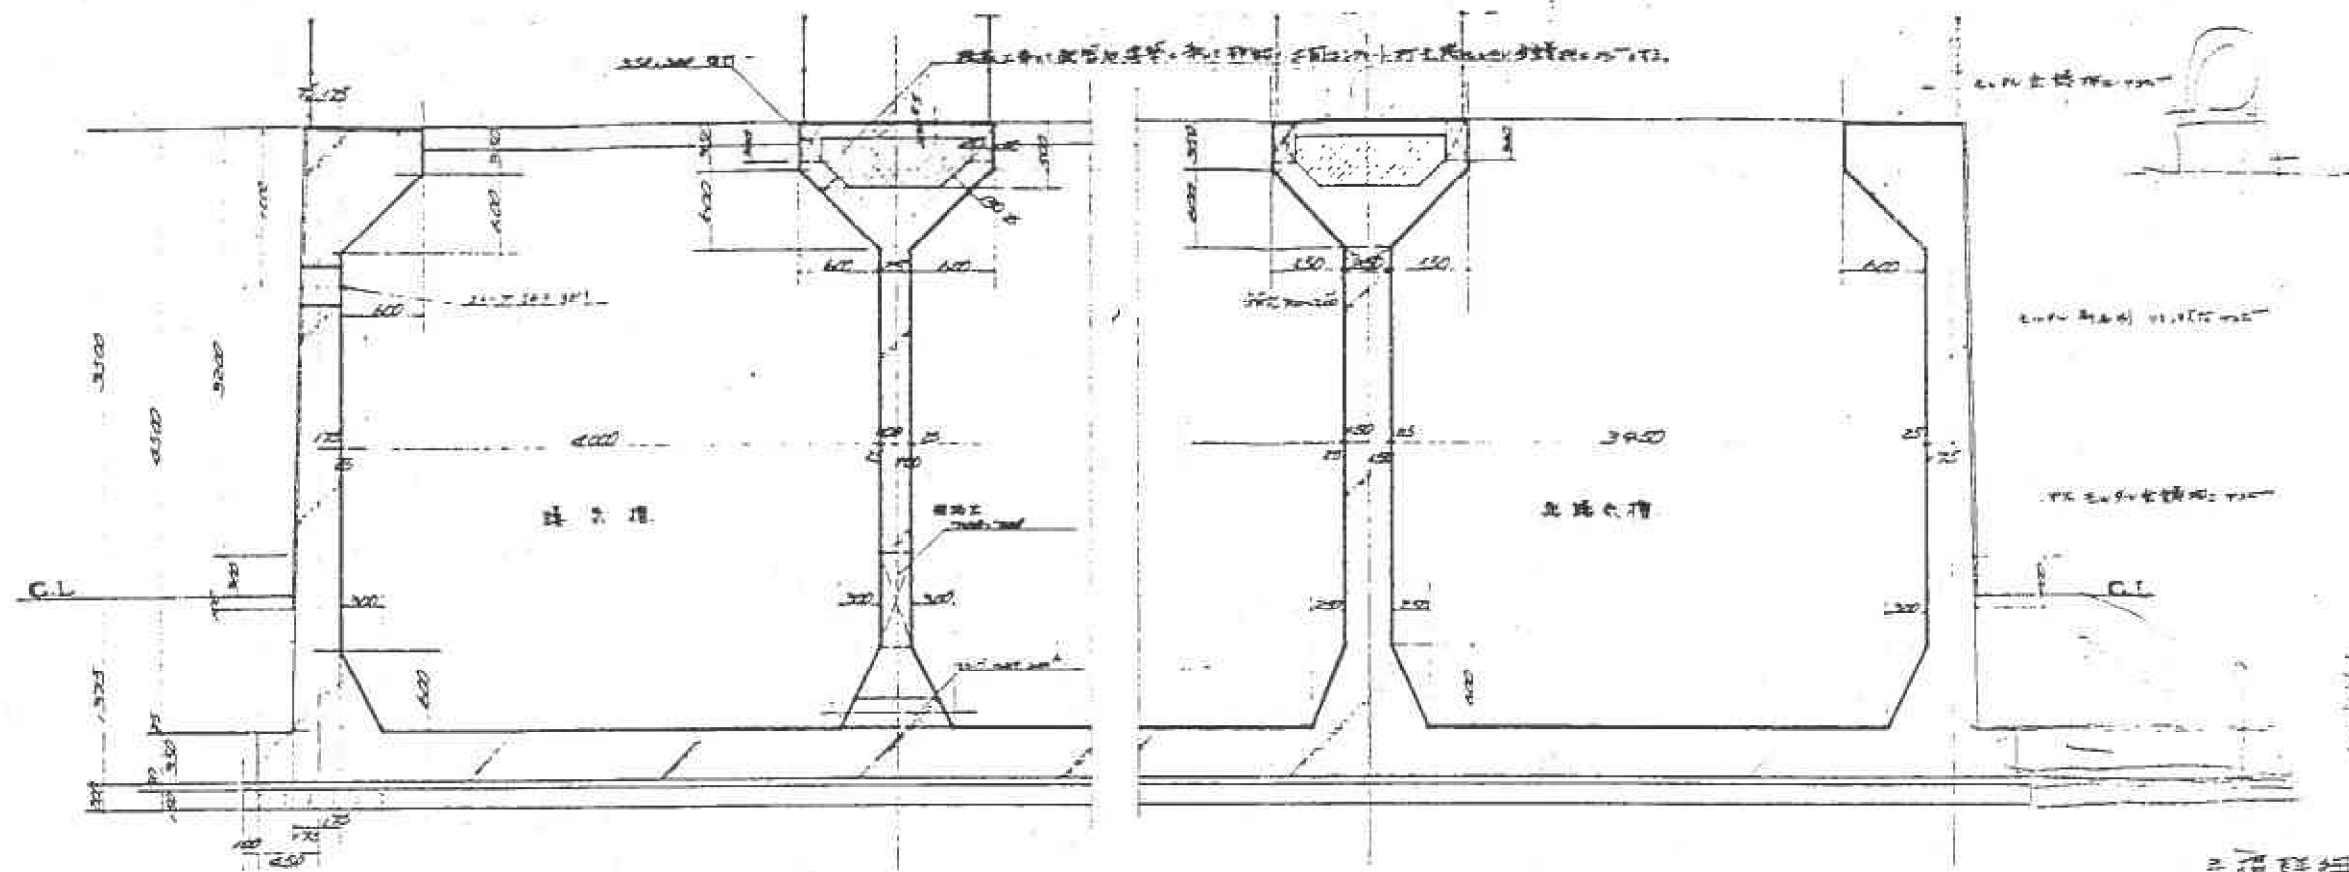


竣工图

图号	1-000	图名	平面图
比例	1:100	设计	张工
审核		校对	
制图		绘图	
材料		标注	
备注			

上 部 伙 房

下圖 比例 SCALE 1:100

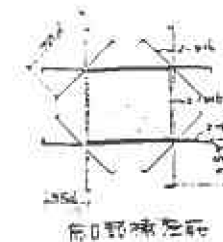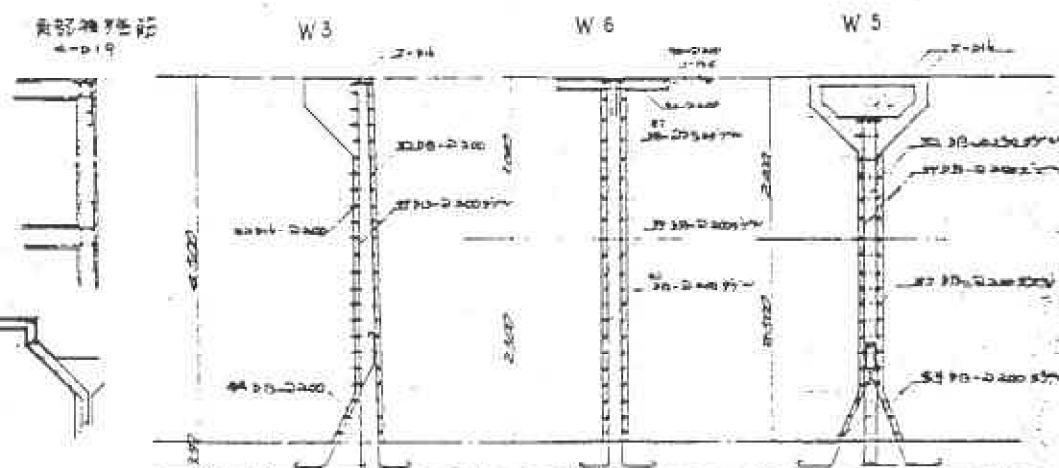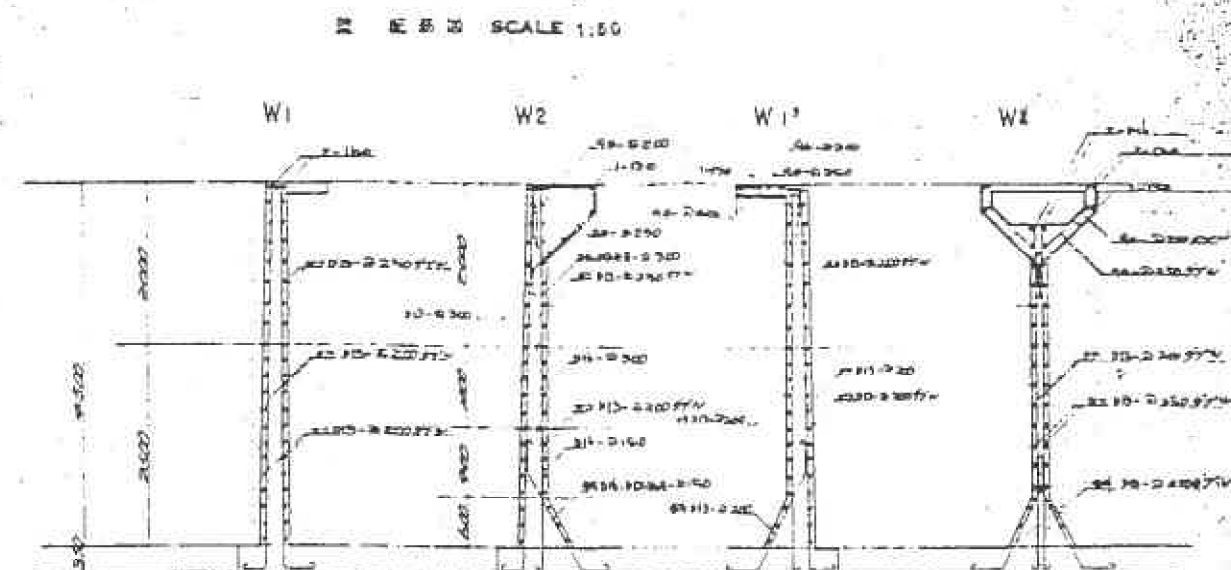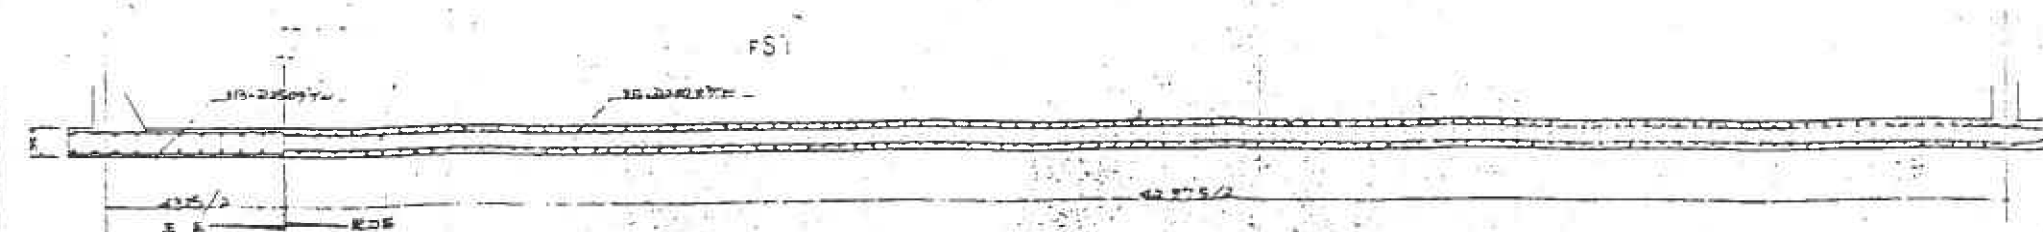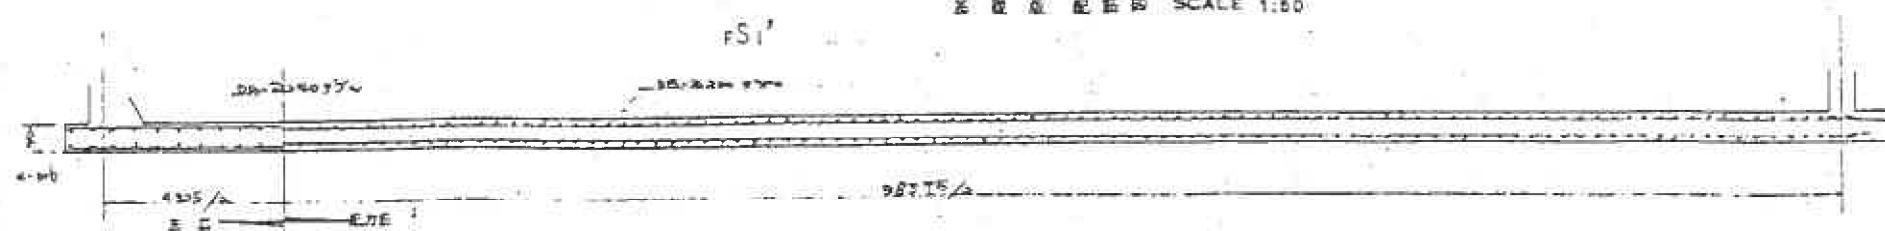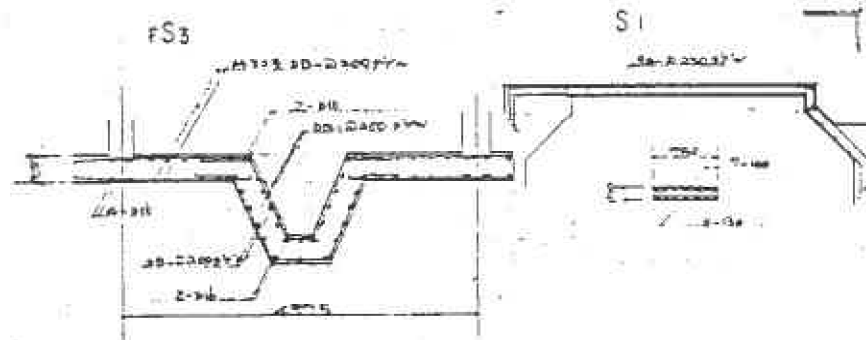


星島日報 1922年11月22日 星期一 12224號

竣工图

[illegible]

SUPPORTING WALL :


DETAIL of REINFORCEMENT

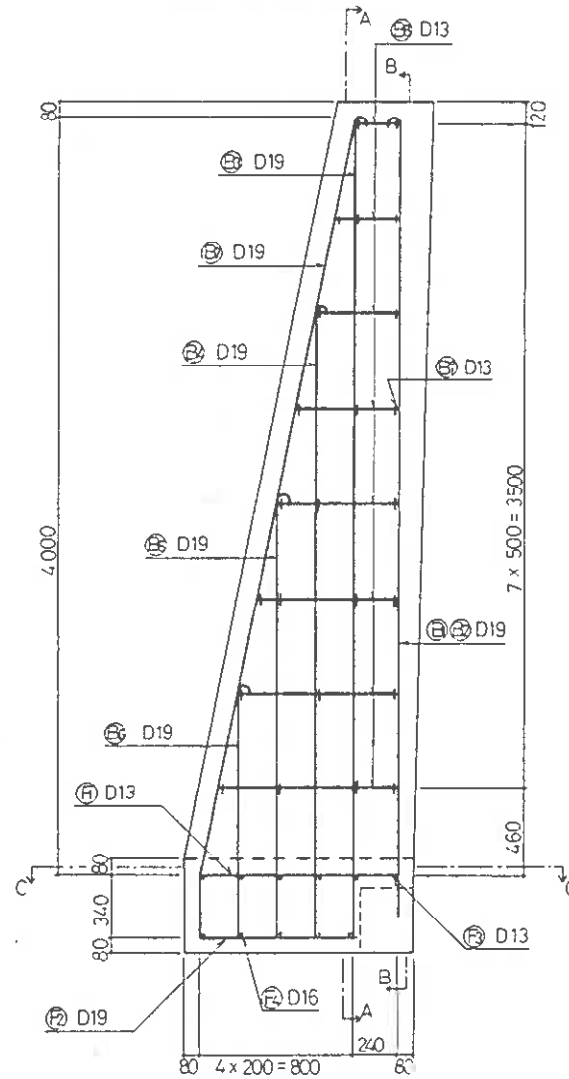

SLAB :


UPPER

LOWER

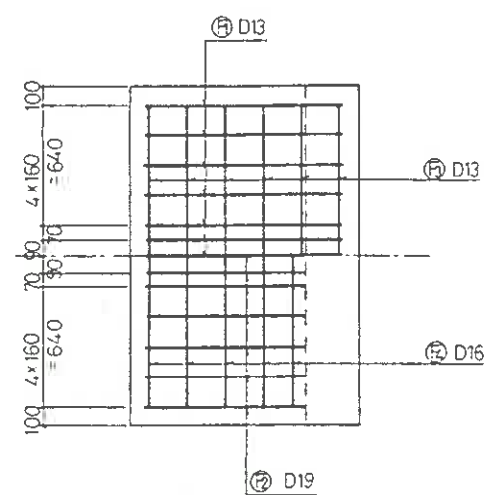


SECTION A-A

SECTION B-B

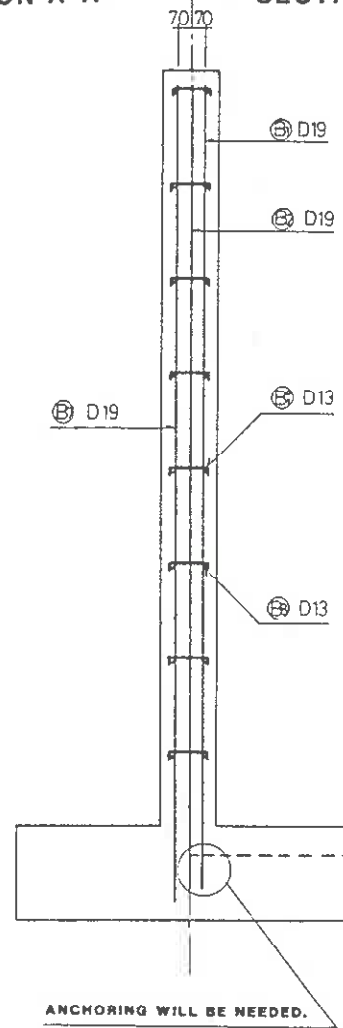

ANCHORING WILL BE NEEDED.


SECTION C-C

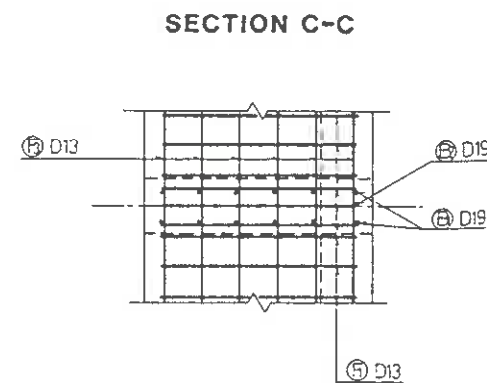

MATERIAL LIST

(一本あたり)

符号	呼称	長さ (mm)	本数	一本の重量 (kg)	重量 (kg)	換算
B1	D19	4 290	2	9.653	19.3	↑
B2	D19	4 290	1	9.653	9.7	↓
B3	D19	4 830	2	10.868	21.7	↓
B4	D19	3 590	2	8.078	16.2	↑
B5	D19	2 590	2	5.828	11.7	↑
B6	D19	1 590	2	3.578	7.2	↑
B7	D19	4 930	2	11.093	22.2	↓
B8	D13	610	16	0.608	9.7	— (平均)
B9	D13	300	24	0.299	7.2	—
F1	D13	1 430	13	1.423	18.5	↓
F2	D19	1 360	13	3.060	39.8	↓
F3	D13	1 600	6	1.592	9.6	—
F4	D16	1 600	5	2.496	12.5	—
D 13				45.0		
D 16				12.5		
D 19				147.8		
鉄筋総重量				205.3		
型 枠				10.2 m ²	コンクリート体積	2.1 m ³

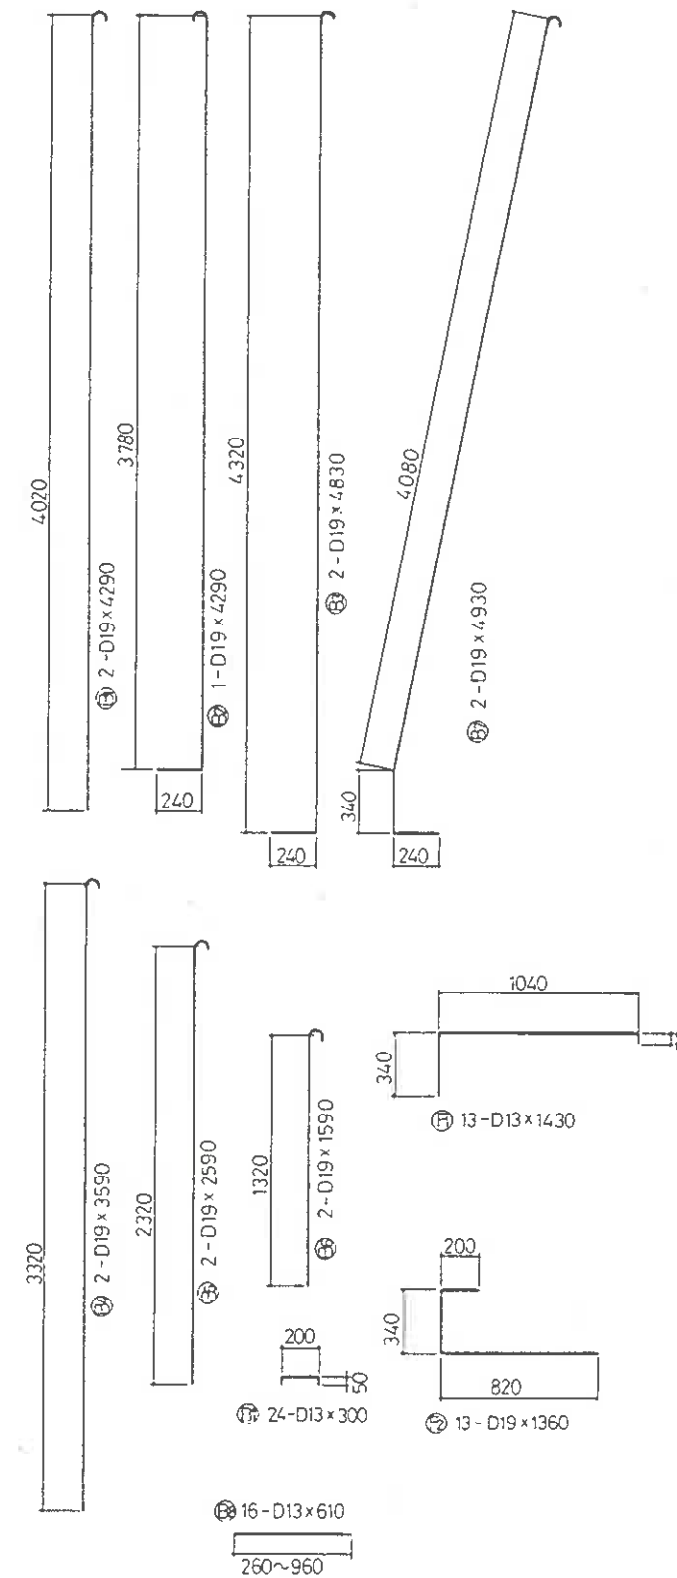

SCALE 1 : 20 (mm)

承認 印	1	2	3	図 名	暖気管支え壁 配筋図及び詳細				縮尺
	4	5	6						1/20
				提出日				平成 元年 3 月 31 日	